


Harvist Hills
 Town of North Benn
 Paron Acres
 303 Village Customers
 meter Filtration Plant

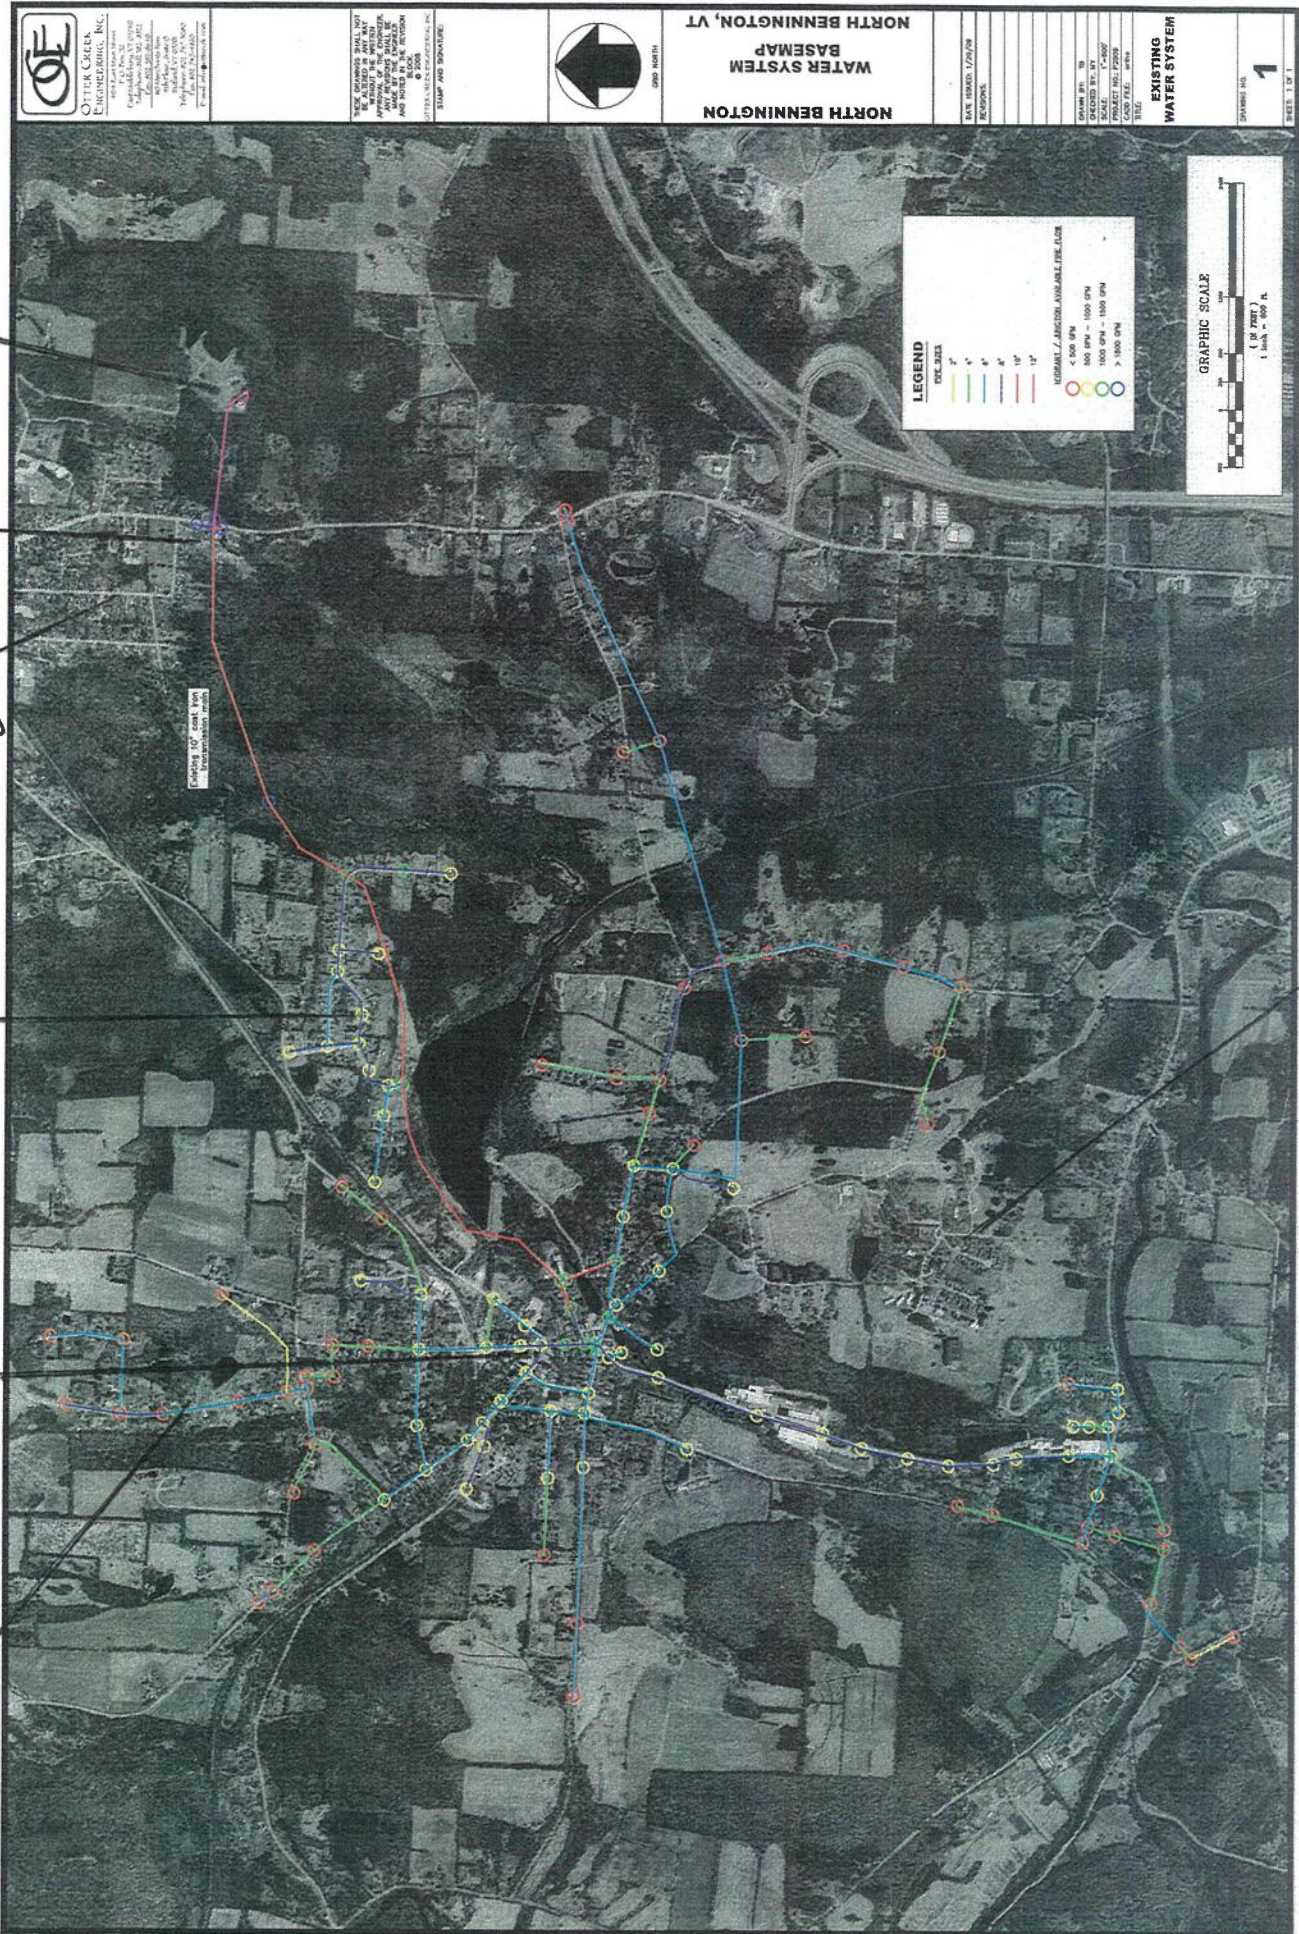

Red line
Main line

Blue lines
Distribution
System

Bennington
College